
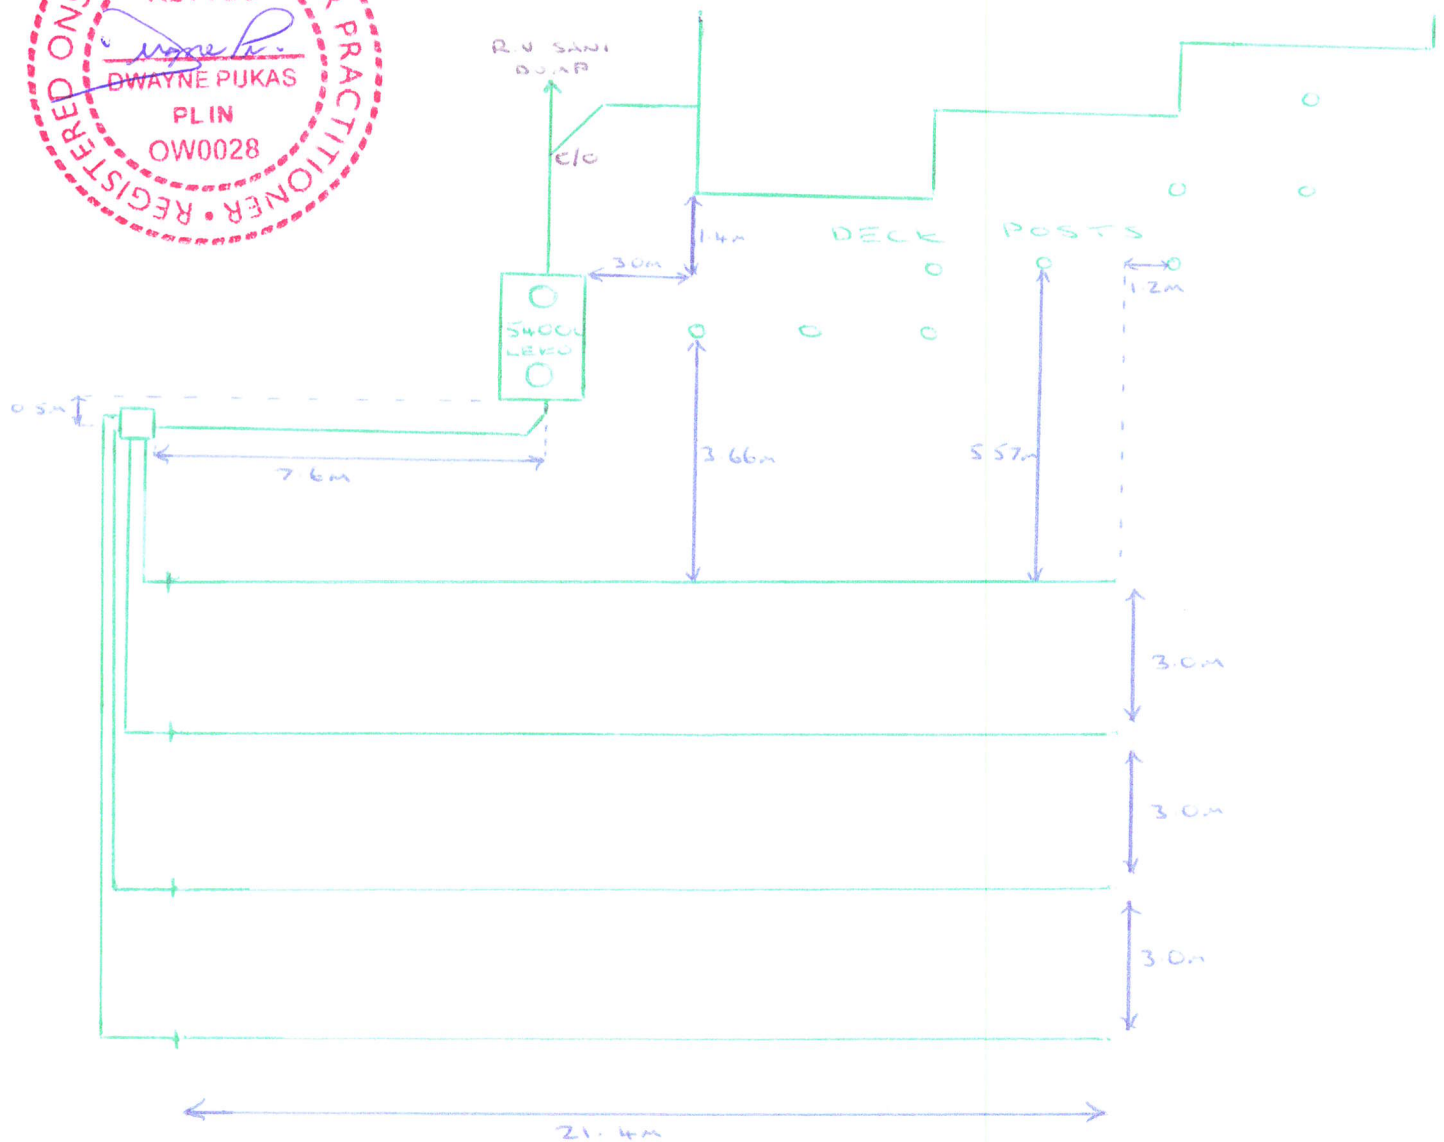


SYSTEM AS BUILT:

Roll # 322-03058.020

4641 56 STREET N.W. SALMON ARM,
B.C. V1E 0B2

LOT 1, SECTION 29, TOWNSHIP 20,
RANGE 10 W6 MERIDIAN, K.D.Y.D.
PLAN KAP 85703

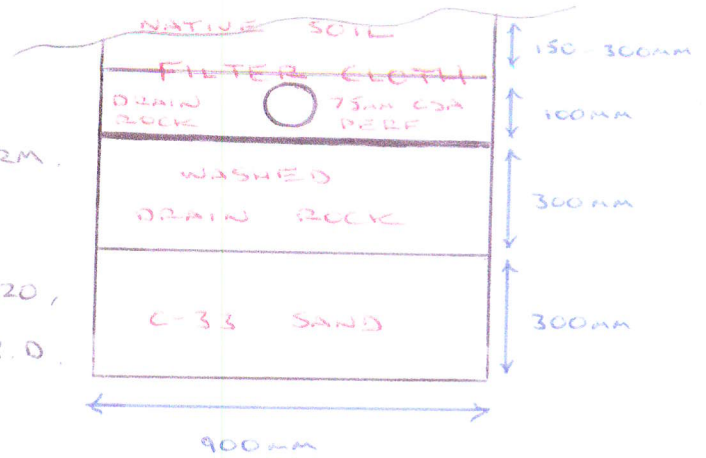

NOTE: PLANS ARE NOT TO SCALE

SITE PLAN:

SEPTIC LOCATION

N.T.S. - APPROX. - SEE DETAIL PLAN

